

**1** EXISTING FIRST FLOOR PLAN- 11,358 SF  
 SCALE: 3/32"=1'-0"  
 0 1 2 4 8



316 S. Clinton Street, 2nd Floor  
 Syracuse, NY 13202  
 315-766-1128  
 labellapc.com

It is a violation of New York Education Law Article 145 Sec.7209, for any person, unless acting under the direction of a licensed architect, professional engineer, or land surveyor, to alter an item in any way. If an item bearing the seal of an architect, engineer, or land surveyor is altered; the altering architect, engineer, or land surveyor shall affix to the item their seal and notation "altered by" followed by their signature and date of such alteration, and a specific description of the alteration.

DRAWING TITLE: **EXISTING FIRST FLOOR PLAN**


PROJECT NAME: **890 7TH NORTH STREET, LIVERPOOL NY 13088**

REVISION:

**BASE PLANS**

DRAWN BY: JO	DATE: 3/15/2022	PROJECT NUMBER: NA
-----------------	--------------------	-----------------------

REVISED SHEET/DETAIL NO.: <b>ASBUILT</b>	SHEET NUMBER: <b>A101</b>
---	------------------------------

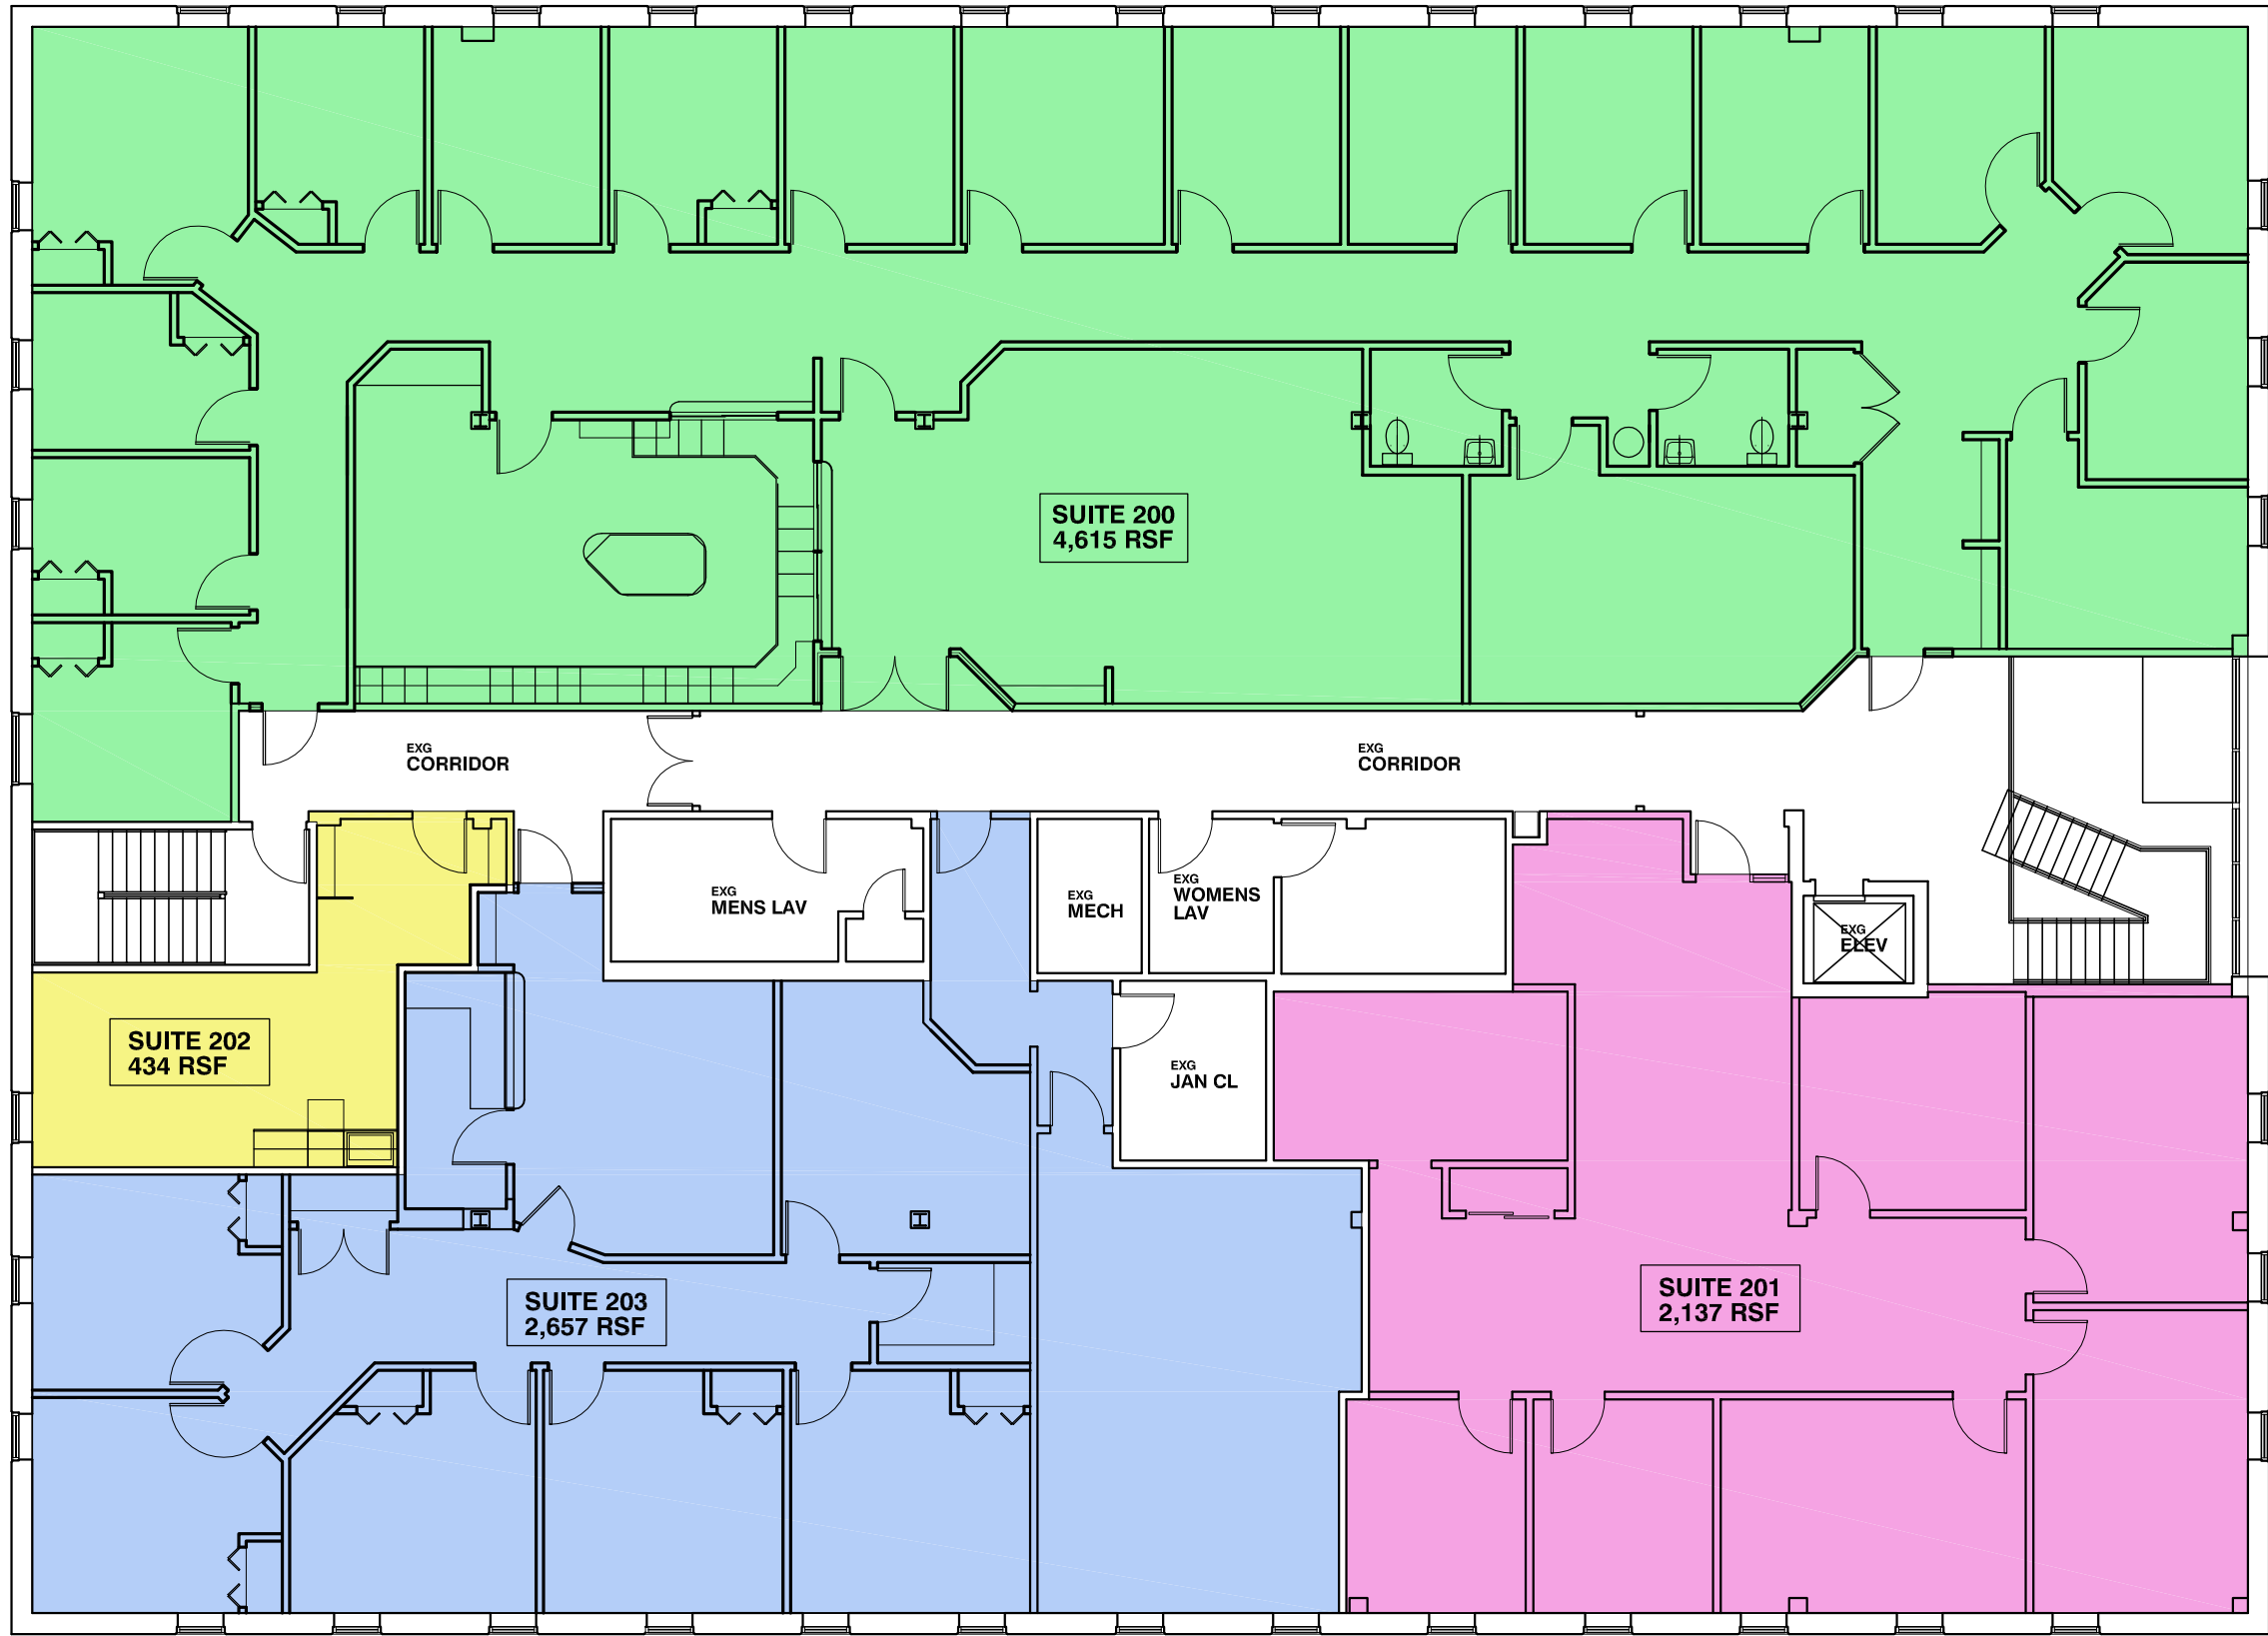

**1** EXISTING SECOND FLOOR PLAN- 11,358 SF  
 SCALE: 3/32"=1'-0"  
 0 1 2 4 8



316 S. Clinton Street, 2nd Floor  
 Syracuse, NY 13202  
 315-766-1128  
 labellapc.com

It is a violation of New York Education Law Article 145 Sec.7209, for any person, unless acting under the direction of a licensed architect, professional engineer, or land surveyor, to alter an item in any way. If an item bearing the seal of an architect, engineer, or land surveyor is altered; the altering architect, engineer, or land surveyor shall affix to the item their seal and notation "altered by" followed by their signature and date of such alteration, and a specific description of the alteration.

DRAWING TITLE: **EXISTING SECOND FLOOR PLAN**

PROJECT NAME: **890 7TH NORTH STREET, LIVERPOOL NY 13088**

REVISION: **BASE PLANS**

DRAWN BY: <b>JO</b>	DATE: <b>3/15/2022</b>	PROJECT NUMBER: <b>NA</b>
---------------------	------------------------	---------------------------

REVISED SHEET/DETAIL NO.: <b>ASBUILT</b>	SHEET NUMBER: <b>A102</b>
--	---------------------------